


NOTE: FOR UTILITY INFORMATION
IN THIS AREA SEE CIVIL DWGS.
NO. 901-101

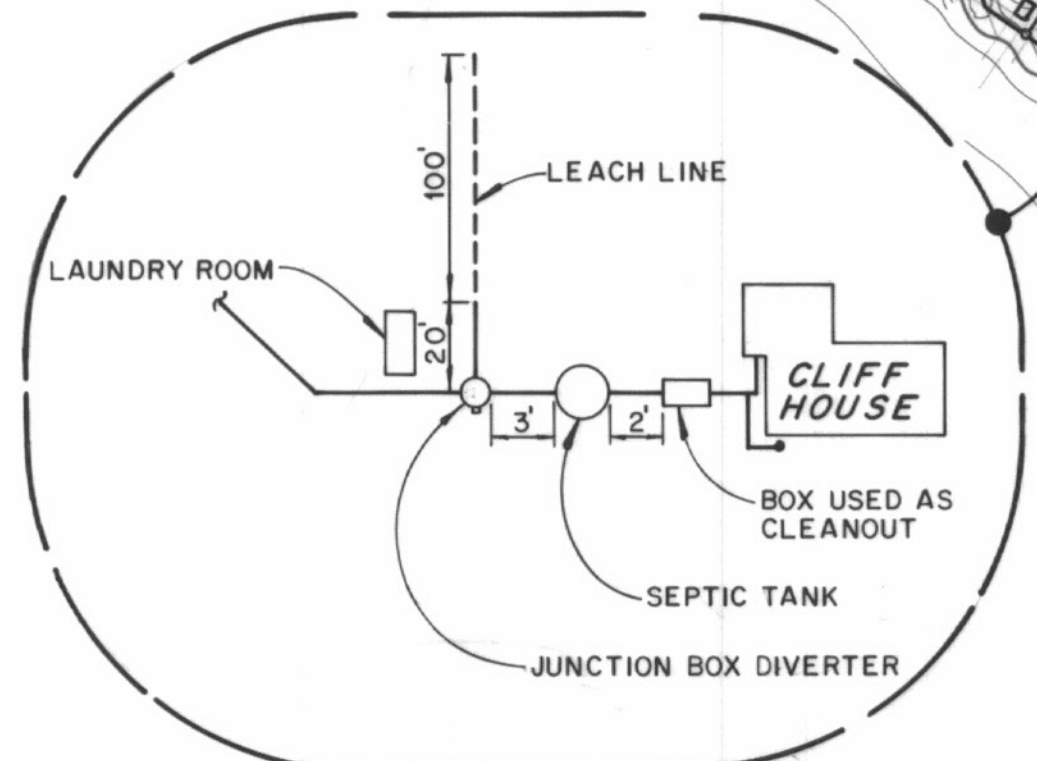

REVISIONS			
DWG. NO.	DESCRIPTION	DWG. DATE	AS-BUILT DATE

SCALE 1" = 200'		WEST CAMPUS ATLAS	
DRAWN BY C. E. P.		SANITARY SEWER DISTRIBUTION SYSTEM	
DATE 12-9-88		DEVEREUX PROPERTY	
CHECKED BY R. K. F.		UNIVERSITY OF CALIFORNIA	
DATE		SANTA BARBARA	
DWG. NO.	13-138	PROJ. NO.	1 OF 1
PLANNING & CONSTRUCTION • FACILITIES MANAGEMENT			