


POOL AREA ELECTRICAL PLAN
SCALE: 1/4" = 1'-0"

ELECTRICAL GENERAL NOTES:

1. ENTIRE ELECTRICAL INSTALLATION SHALL BE IN ACCORDANCE WITH ALL APPLICABLE SECTION OF ART. 240, 250, 260, 9990, 10000.

ELECTRICAL PLAN NOTES:

1. STUD CONDUIT WITH INSIDE OF COLUMN TO REFIN GRADE. MAINTAIN CONTINUITY OF CIRCUIT GROUND.
2. TELEPHONE TERMINAL BACKWARD. PROVIDE 1/2" CU TO COLD WATER PIPE FOR GROUND. STUD (1) 2" CU CUT INTO UTILITY TRENCH. CAP & MARK FOR FUTURE TELE-SERVICE.
3. MAIN METER SECTION. REFER TO SHEET E-5 FOR SINGLE LINE DIAGRAM.
4. RUN HOME RUN IN P.C.C. BACK TO PANEL #HPR1. PROVIDE SEPARATE PULL WIRE FOR 1/2" EQUIPMENT. (PROVIDED, INSTALLED AND CONNECTED BY POOL CONTRACTOR).

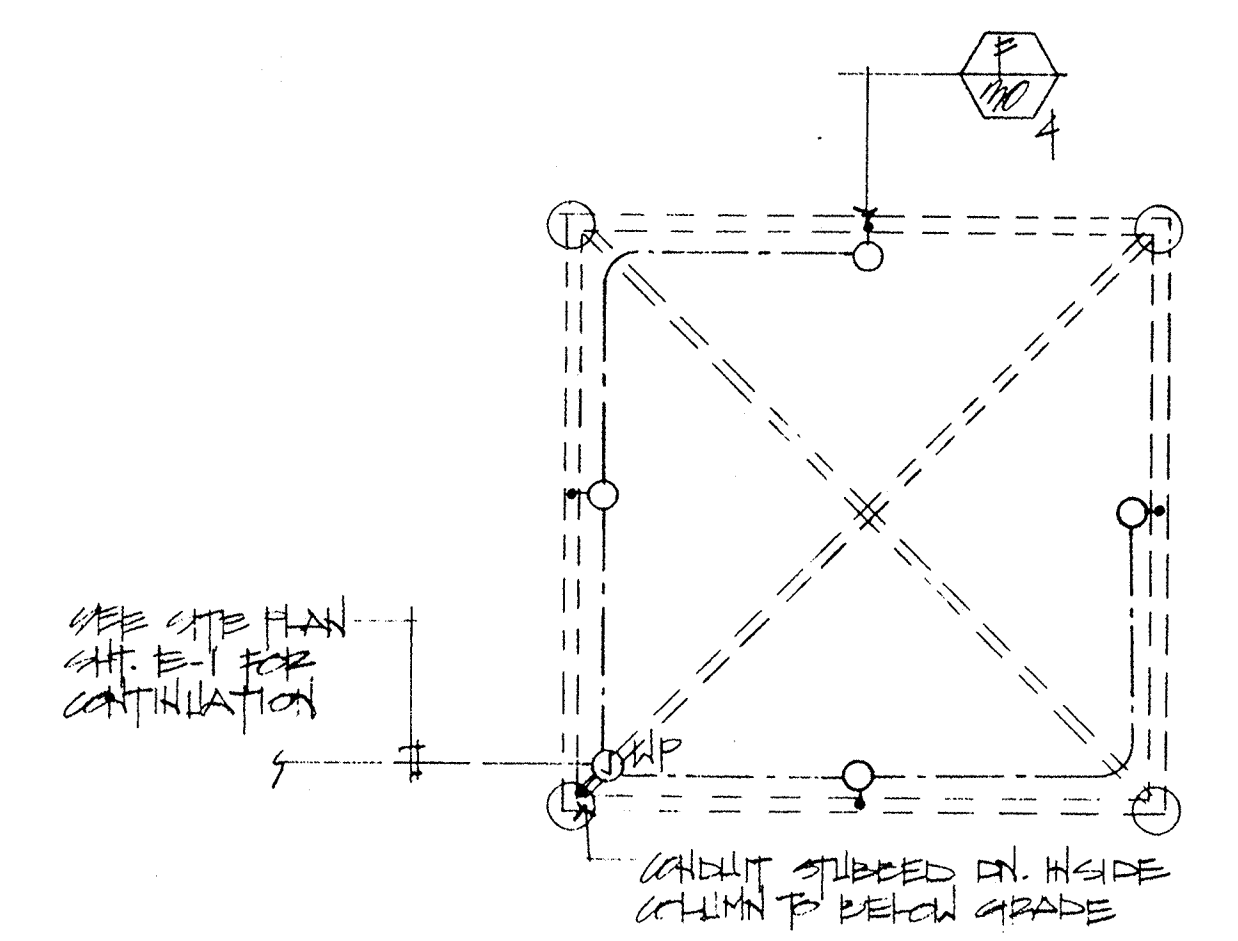

POOL AREA ELECTRICAL PLAN
SCALE: 1/4" = 1'-0"

no.	date	by
revision		
IBI Group		
Architects and Planners L. Paul Zajfen		
2865 E. Coast Highway Suite 303 Corona Del Mar, Ca. 92625 (714)975-2390		
consultants		
RWR ASSOCIATES		
290 ARWAY AVENUE, SUITE 200 • COSTA MESA, CA 92626 714/441-1015		
project title		
U · C · S · B		
sheet title		
POOL AREA ELECTRICAL PLAN		
scale	date	
4" = 1'-0"		
drawn	checked	
J. RICHESBY		
project no.	sheet no.	
	E-7	
of 10		
<small>This drawing, as an instrument of service, is the property of the architects and may not be reproduced without their permission and unless the reproduction carries their name. All designs and other information shown on this drawing are for use on the specified project only and shall not be used otherwise without written permission of the architects.</small>		
<small>Written dimensions shall have precedence over scaled dimensions. Contractors shall verify and be responsible for all dimensions and conditions on the job and the architect shall be informed of any variations from the dimensions and conditions shown on the drawing. Shop drawings shall be submitted to the architect for approval before proceeding with fabrication.</small>		
AS BUILT WALTON ELECTRIC CORP. 1-31-87 2865 E. Coast Highway Corona Del Mar, CA 92625		