

10/6/87 ADD AS-BUILT INFO/ADD HEADS
 4-27/87 AS-BUILT
 6/23/86 RE DELETE VOLLEY BALL
 4/30/86 REV. ROAD ALLOW & GUTTER C'
 BUILDING & DRIVE ONE

no.	date	by
revision		

BI Group
 Architects and Planners
 L. Paul Zajen
 359 San Miguel Drive
 Suite 200
 Newport Beach, California
 92660
 (714) 844-4291


EDWARD E. GRIPP
 LICENSED LANDSCAPE ARCHITECT
 2181 Victoria Ave.
 Orange, CA 92668
 (800) 885-7871

project title
U.C.S.B.

sheet title
IRRIGATION PLAN AS BUILT

scale	1"=20'-0"	date	7/31/85
drawn	ED GRIPP	checked	
project no.		sheet no.	L-4

This drawing, as an instrument of service, is the property of the architects and may not be reproduced without their permission and unless the reproduction carries their name. All designs and other information shown on this drawing are for use on the specified project only and shall not be used otherwise without written permission of the architects.
 *Written dimensions shall have precedence over scaled dimensions. Contractors shall verify and be responsible for all dimensions and conditions on the job and the architects shall be informed of any variations from the dimensions and conditions shown on the drawing. Shop drawings shall be submitted to the architects for approval before proceeding with fabrication.

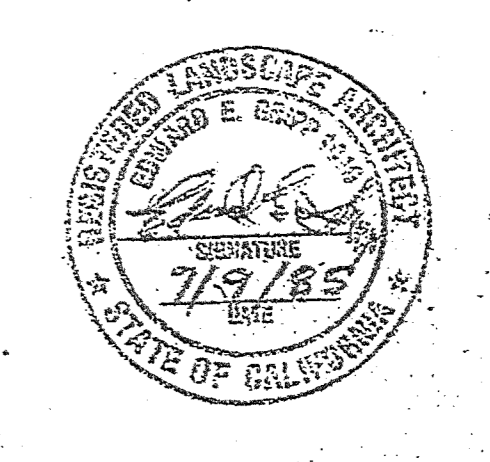

STATIC WATER PRESSURE IS 55 P.S.I.

