GOLDRICH & KEST
U.C.S.B. FACULTY HOUSING
SANTA BARBARA

OPTIONAL PAINT GRADE BOOKCASE

5 FIXED INTERIOR SHELVES IN EACH OPENING

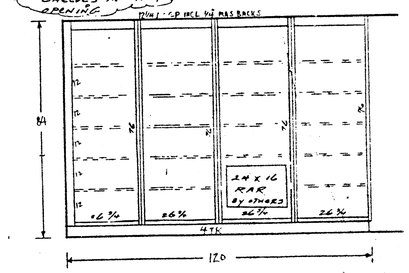

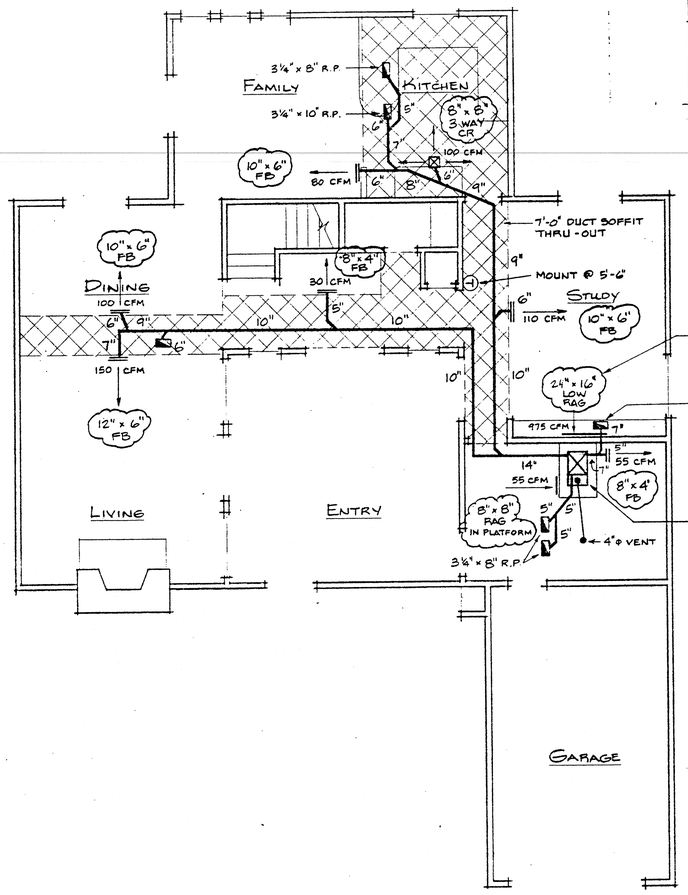

FIRST FLOOR

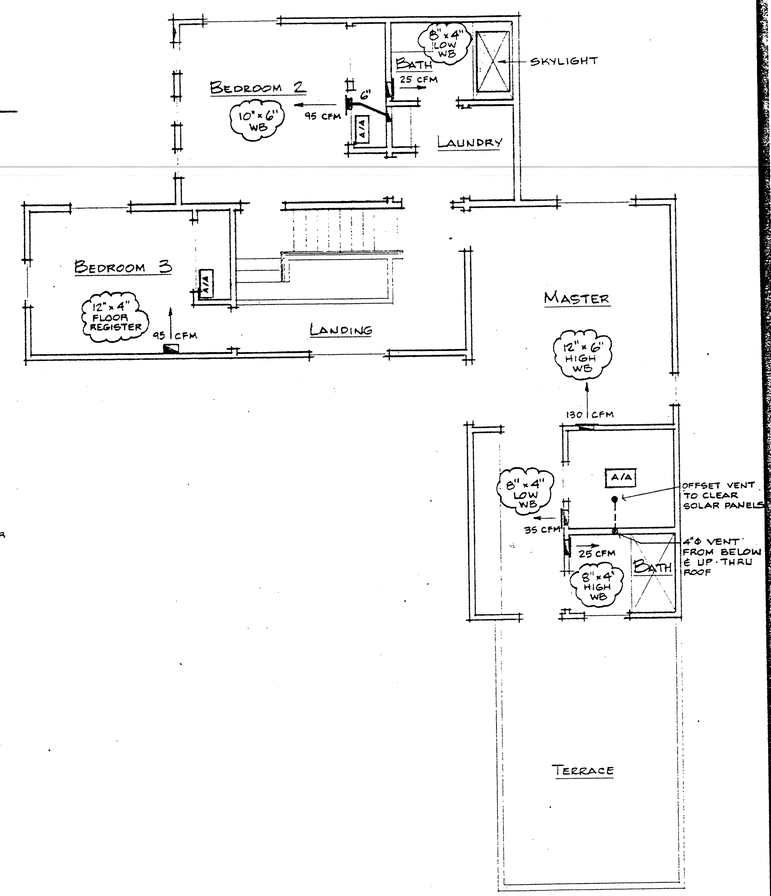

SECOND FLOOR

AS BUILTS
2/13/87
KAM

UNIT 2

REVISIONS	BY
24 x 16 PAINT GRADE CABINET STEP	ARM 10/7/86

IrvineWest
HEATING & AIR CONDITIONING, INC.
1301 E. PACIFICO AVENUE
ANAHEIM, CALIF. 92805
(714) 634-2718

MECHANICAL LAYOUTS

GOLDRICH & KEST
UCSB FACULTY HOUSING
SANTA BARBARA, CA

DATE: 10-10-85
SCALE: ¼" = 1'-0"
DRAWN: S CARLSON
SHEET: 2 of 2
JOB: 845